



LEGEND

	SINGLE 13A SOCKET OUTLET
	TWIN 13A SOCKET OUTLET
	FUSED CONNECTION OUTLET
	UNSWITCHED FUSED CONNECTION UNIT
	KEY SWITCHED FUSE CONNECTION UNIT
	UNSWITCHED 13A SOCKET
	FUSED CONNECTION UNIT ON TIME SWITCH
	TV OUTLET
	SINGLE 13A CLEANERS SOCKET
	SINGLE 13A IP65 RATED SOCKET
	COOKER SUPPLY SWITCH
	TV AERIAL SPLITTER/BOOSTER
	POWER SUPPLY UNIT IN CEILING VOID
	INDUCTION LOOP
	HAND DRYER
	DISABLED ALARM INDICATOR LIGHT
	DISABLED ALARM RESET BUTTON
	DISABLED ALARM PULL CORD
	TRIPLE POLE FOR ISOLATOR AT H/L
	CONTAINMENT RISE/DROP
	UNDERFLOOR HEATING ZONE THERMOSTAT
	3 POSITION ROOF LIGHT CONTROL SWITCH
	FLEX OUTLET PLATE
	DISTRIBUTION BOARD
	MECHANICAL CONTROL PANEL
	DOOR ENTRY PANEL
	MECHANICAL EXTRACT FAN
	PIR FOR MECHANICAL EXTRACT FAN
	GALVANIZED STEEL TRUNKING
	DENOTES BOXING IN AT CABLE CONTAINMENT
	GALVANIZED STEEL CABLE BASKET
	3 COMPARTMENT FLUSH FLOOR TRUNKING
	3 COMPARTMENT DADO TRUNKING
	3 COMPARTMENT SKIRTING TRUNKING
	TRIPLE POLE AND NEUTRAL ISOLATOR RATED AT 63AMPS
	POWER SUPPLY EXPANSION UNIT
	DOOR BELL
	DOOR BELL TRANSFORMER INCLUDING DIN RAIL ENCLOSURE
	BONDING POSITION
	ELECTRIC WINDOW INTERFACE
	AT LOW LEVEL
	AT MID LEVEL
	AT HIGH LEVEL
	DATA CABINET
	TWIN DATA OUTLET
	SINGLE TELEPHONE OUTLET
	INTRUDER ALARM PANEL
	INTRUDER ALARM KEY PAD
	INTRUDER ALARM PIR SENSOR
	INTRUDER ALARM DOOR CONTACT
	DOOR RELEASE BUTTON
	EMERGENCY BREAK GLASS TO EXIT
	DOOR ENTRY KEY PAD
	DOOR BELL SOUNDER
	AV PROJECTOR
	2 GANG RECESSED BACK BOX FOR FUTURE VOA FACE PLATE
	AMPLIFIER OUTLET

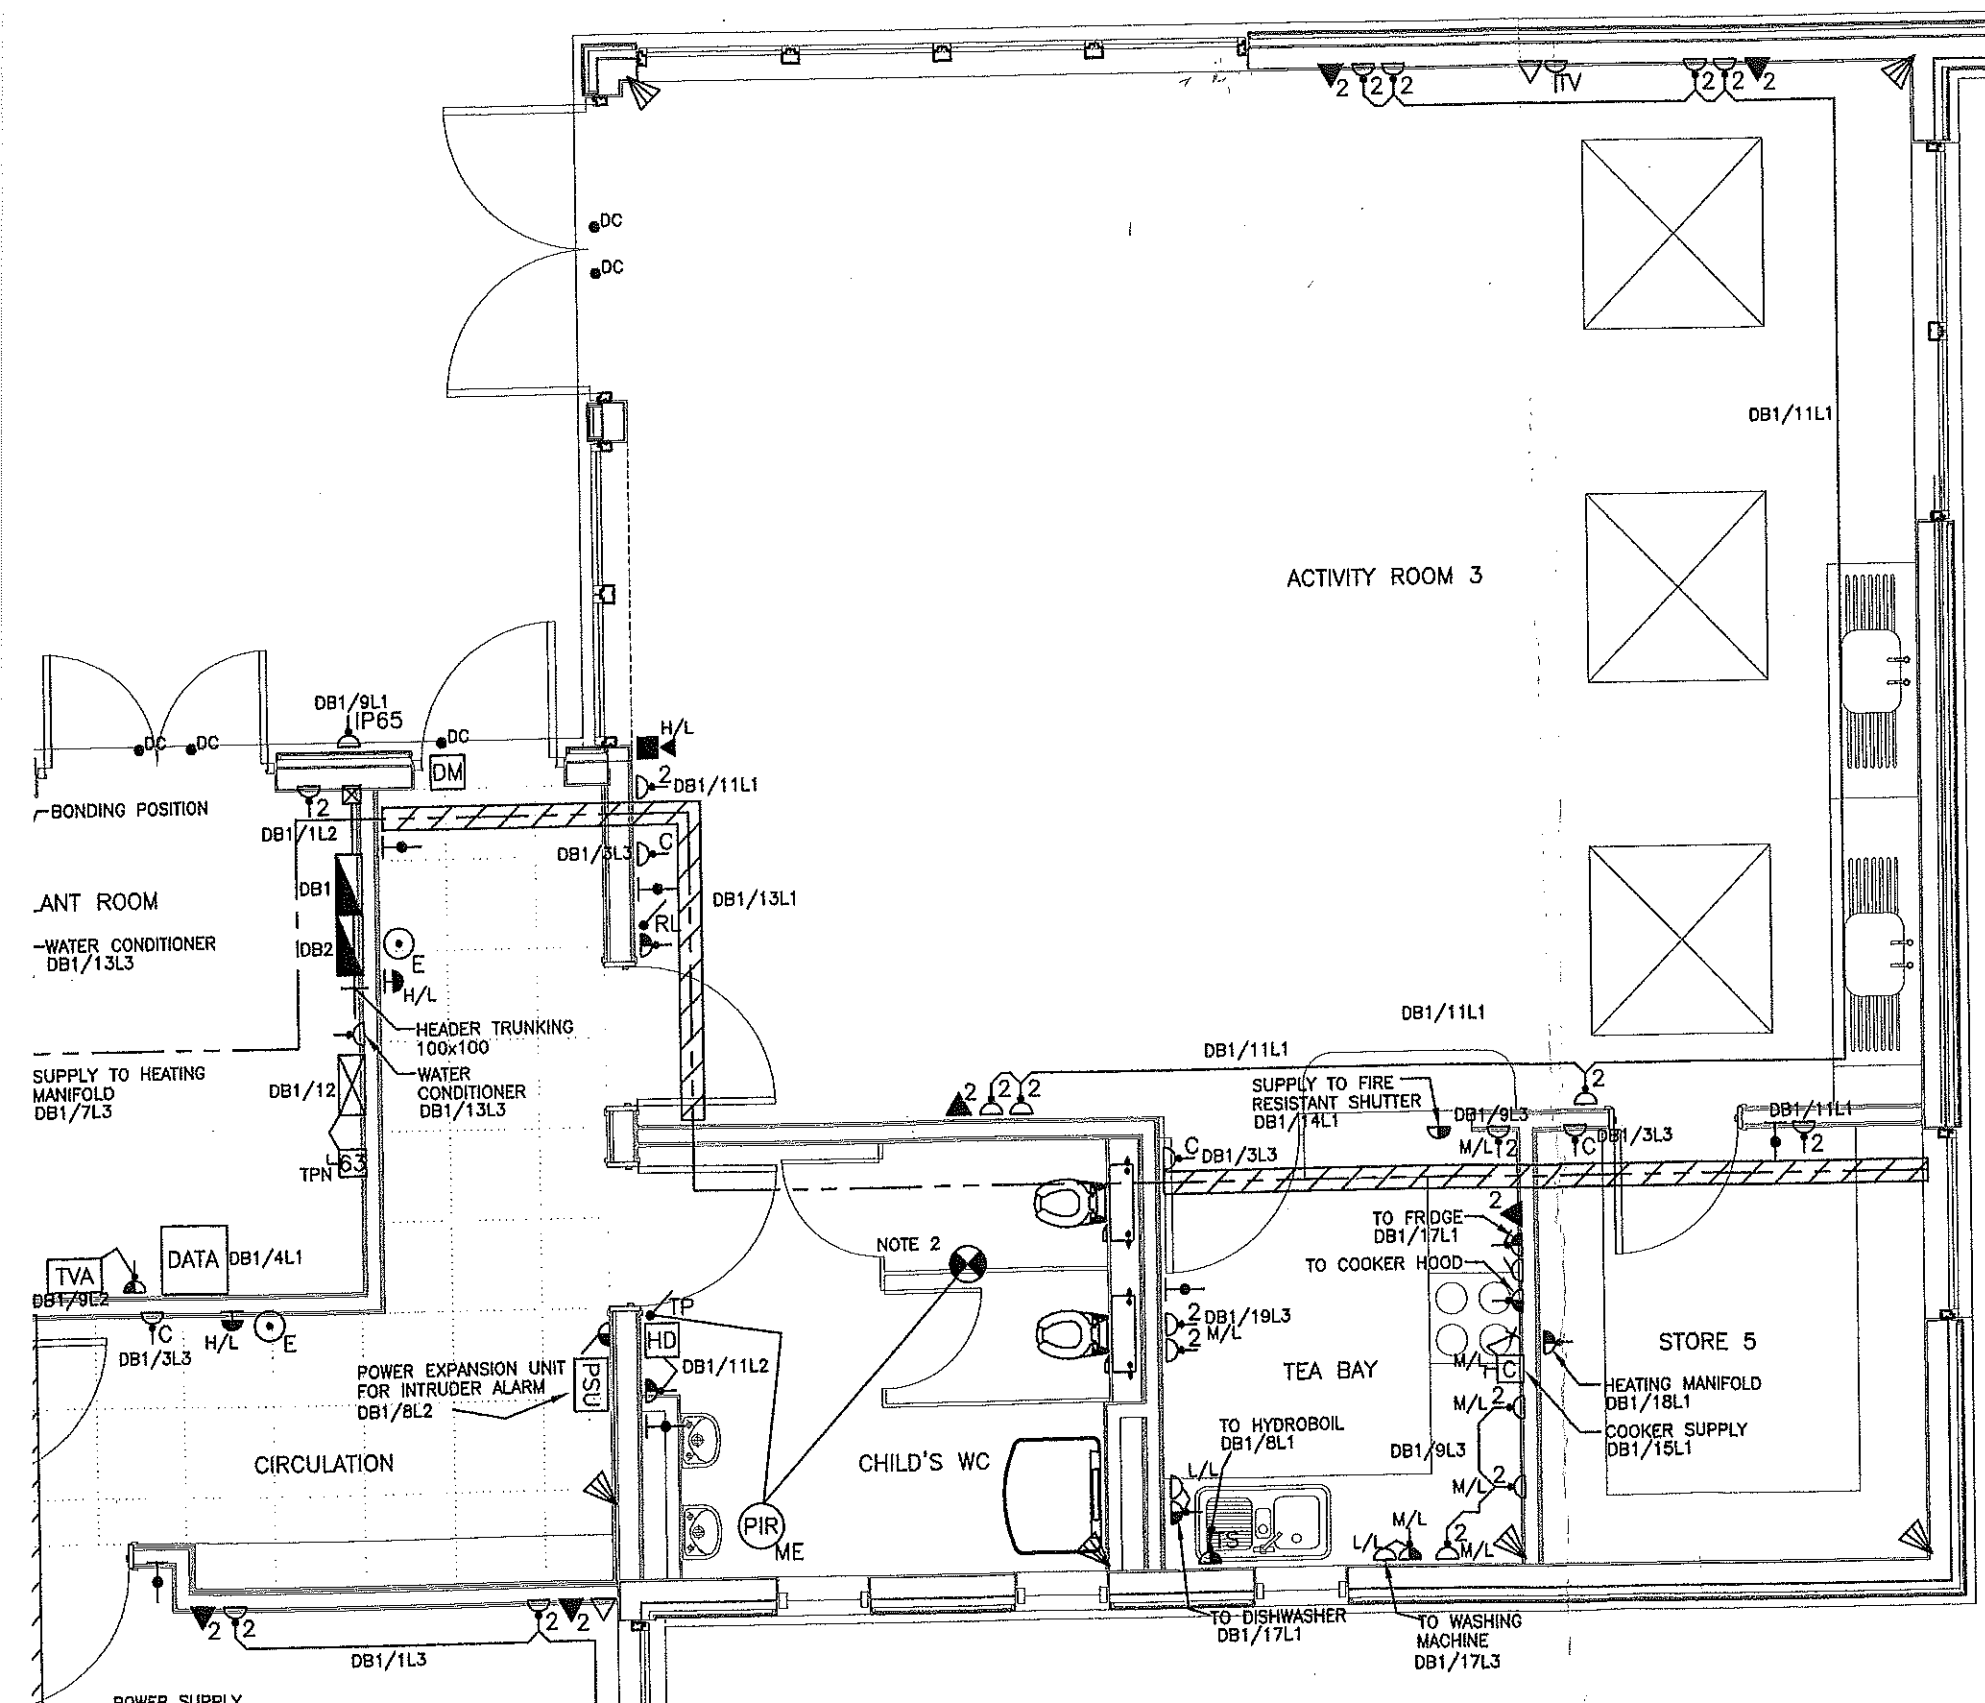

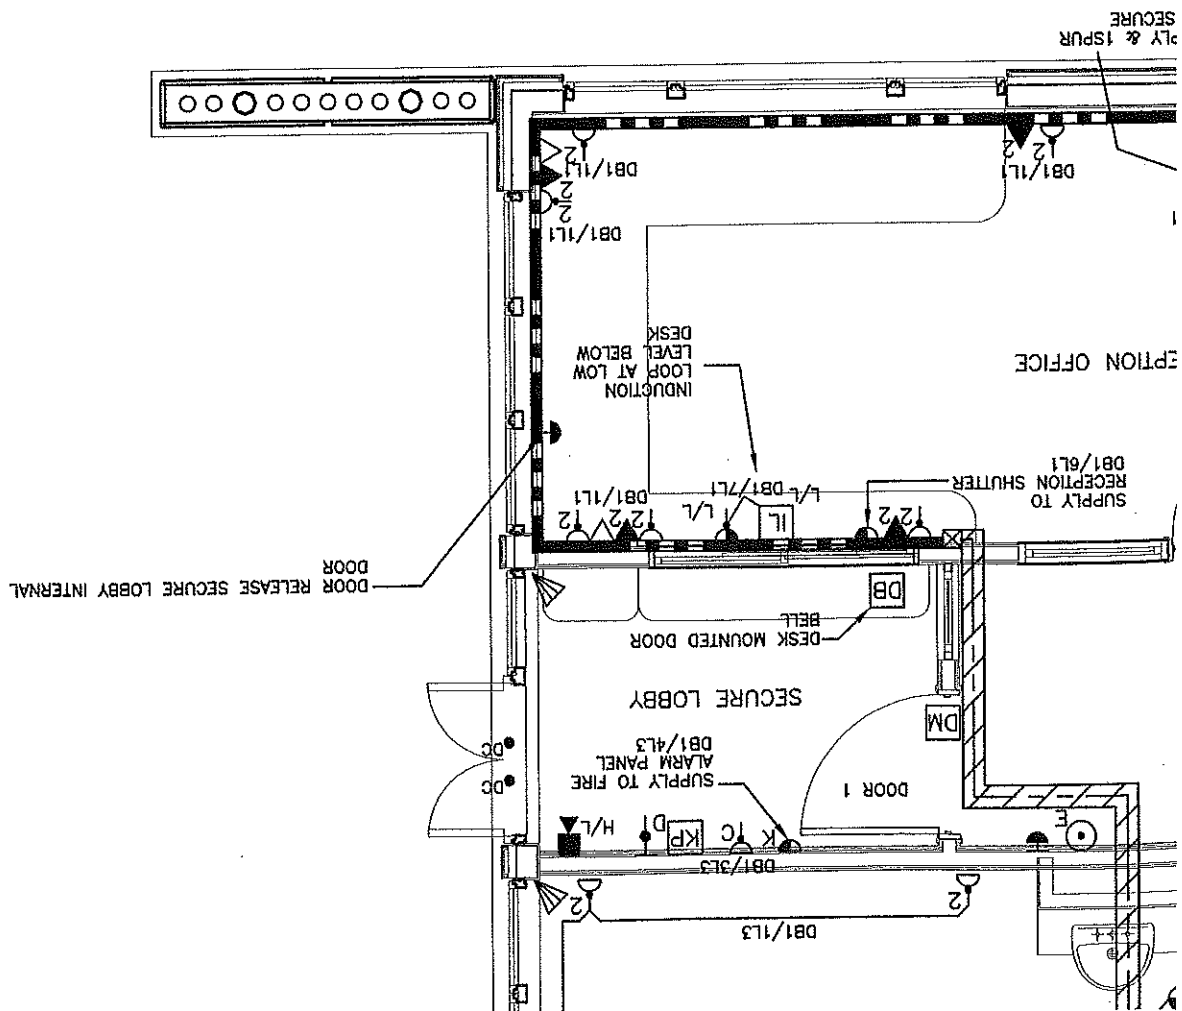

Hanbridge Electrical Ltd.

Unit 9, Horwood Court
Bilton Road
Bletchley
Milton Keynes
MK1 1RD
Tel: 01908 631900
Fax: 01908 631911

Site / Project
Milton Keynes Childrens Centre
Oxley Park Primary School
Redgrave Drive
Milton Keynes
MK4 4TA
Drawing Title


Small Power & Data Layout

Drawn S.H Date 14/05/10

N.T.S

As Installed

Drawing No 3342/E/02 Revision

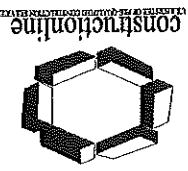

REGISTERED MEMBER
ECA

constructionline

