FLOOR DIMENSIONS

Fitness Suite Mezzanine

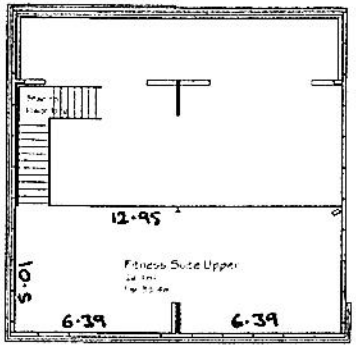

Key

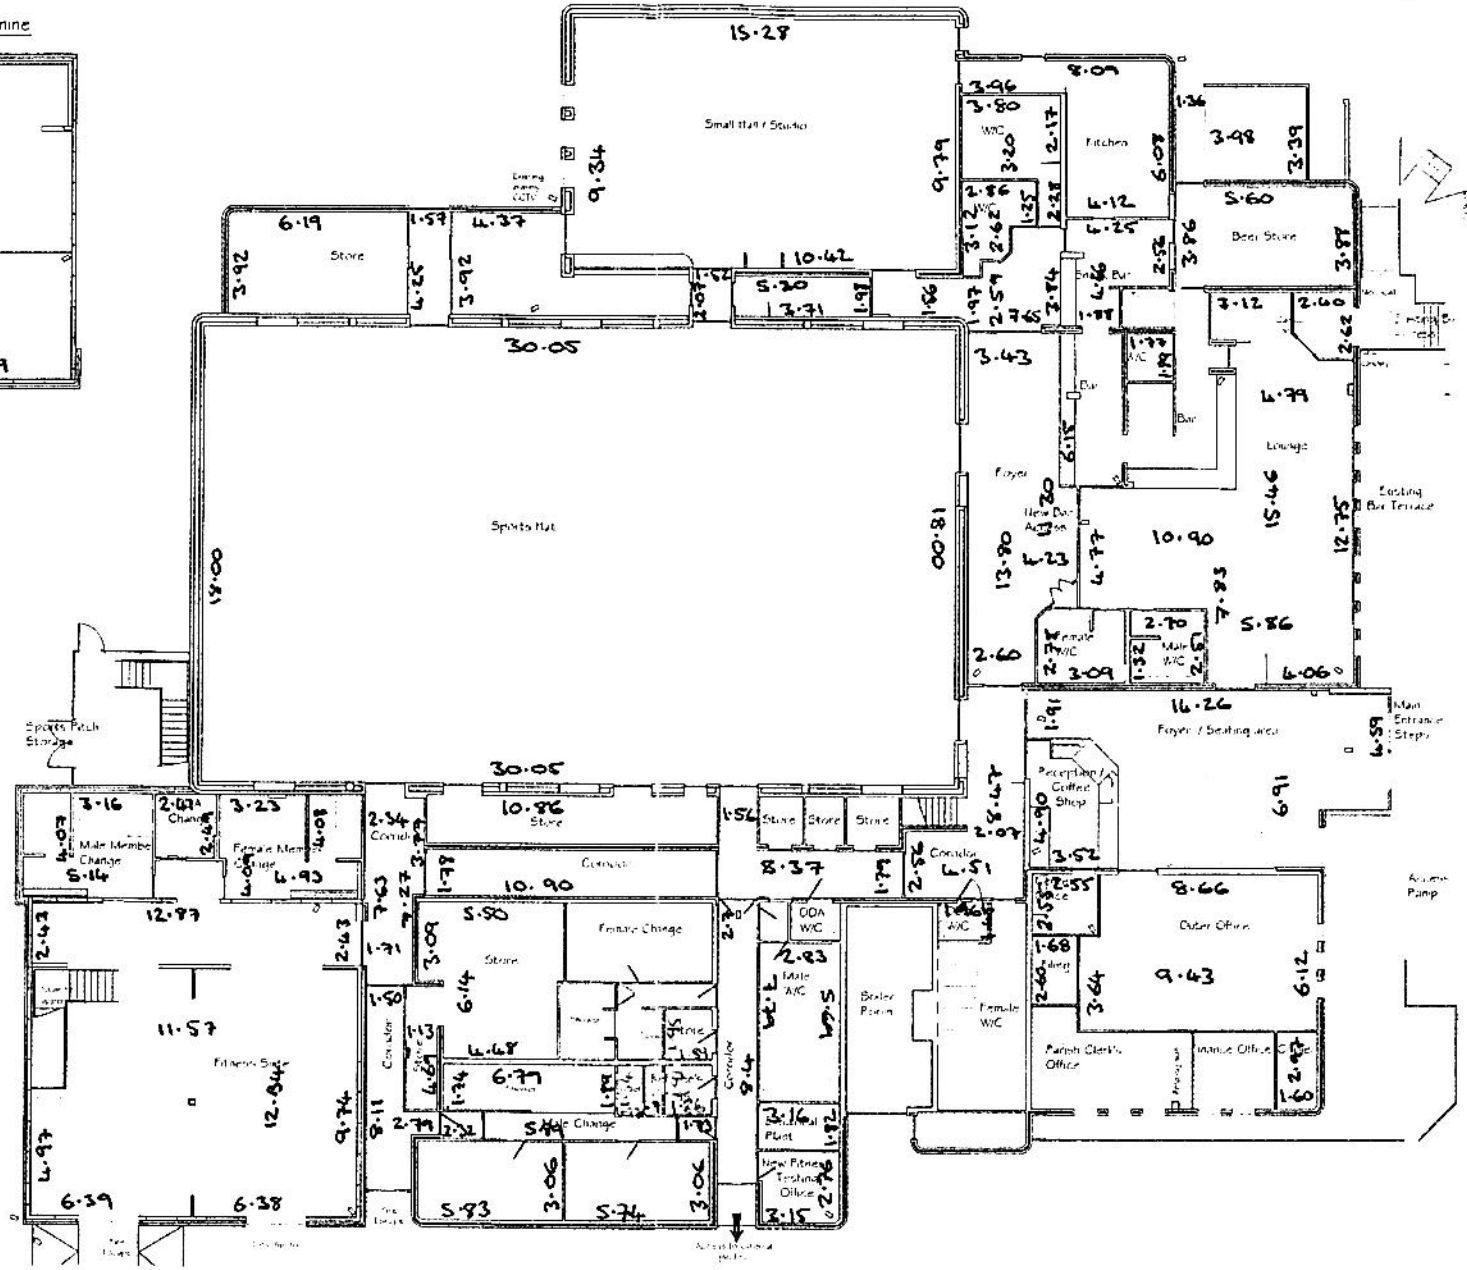

First Floor Offices & Viewing Gallery

As Built

Scale 1:100













CREATEABILITY

Client: Stratton St Margaret Parish
Project: Community Centre Redevel
Location: Grange Dr., Stratton St Margaret SN3 4JY
Title: Cctv Location Plan - As Built

Scale 1:100 @ A3 | Date 03.04.14 | Drawn JH

Drawn by: SSMPC | No. 15-013 | Drawing No. C-135